

September 20, 2023

Via Email/Original by Mail

Address
Address
Address
Address

Dear Interested Party:

**Re: Many Island Pipe Lines (Canada) Limited (MIPL) Pierceland Supply Variance Application
for the Cold Lake – Beacon Hill Decommissioning Project**

Many Island Pipe Lines (Canada) Limited (MIPL), a federally regulated and wholly owned subsidiary of SaskEnergy Incorporated, a Saskatchewan Crown Corporation, is seeking comment with respect to our proposed Pierceland Supply Variance Application (the “Project”).

Many Islands Pipe Lines (Canada) Limited (“**MIPL**”) will soon be applying to the Commission of the Canada Energy Regulator (the “**Commission**”) pursuant to Section 69 of the *Canadian Energy Regulator Act* to vary Order XG-017-2020, as amended, (the “**Order**”) approving the Pierceland Supply Project.

The purpose of the variance is to address approximately 30 metres of MIPL pipeline within the CLBH #1 facility yard site located at SW-12-62-01-W4M, Municipal District of Bonnyville No. 87, Alberta (the Pipeline Segment). This Pipeline Segment predates the Pierceland Supply construction, is not required for the operation of the final installation, and its removal will not impact service under any circumstance. No outage is required to perform the work.

MIPL will be seeking approval for decommissioning of the Pipeline Segment. The NPS 10 pipe begins at a riser and is buried underground up until the fence line just before the metering station.

Subject to any feedback received, the Project Variance Application is anticipated to be submitted to the Commission at the end of September 2023.

As part of our commitment to ensure organizational preparedness and resilience, and to meet regulatory requirements of the Canada Energy Regulator (CER), we are seeking feedback. If you wish to have information considered in our variance application, or require more details, let us know by email as soon as possible.

Information on MIPL’s engagement and land complaint processes can be found on the MIPL’s website at: <https://www.miplcl.com/projects>. CER brochures and publications of interest, including information on the CER are available here: <https://www.cer-rec.gc.ca/prtcptn/gdnccmpnsnbpblctn-eng.html>.

All application materials to date on the Pierceland Supply Project can be seen at: <https://apps.cer-rec.gc.ca/REGDOCS/Item/View/3781663> (or go to the CER website at <http://www.cer-rec.gc.ca/> click on “Applications & Filings” under the heading “View Regulatory Documents, enter the Document Number A99944 and click on “Go”).


Should you wish to contact the CER, please reference file number File OF-Fac-Gas-M182-2019-02 01, [Many Islands Pipe Lines \(Canada\) Limited - Pierceland Supply Project](#). CER's preferred method is online through its e-filing tool which provides step-by-step instructions. If unable to file a document online, it may be filed by email to Secretary@cer-rec.gc.ca. Please copy tjordan@saskenergy.com.

We look forward to your response and hope that you will provide any questions or concerns regarding this important initiative.


If you have any questions or comments, please contact the project team at (306) 570-1546 or email manyislands@saskenergy.com. Thank you.

Sincerely,

Wade Goodwin
Land & Public Awareness Coordinator

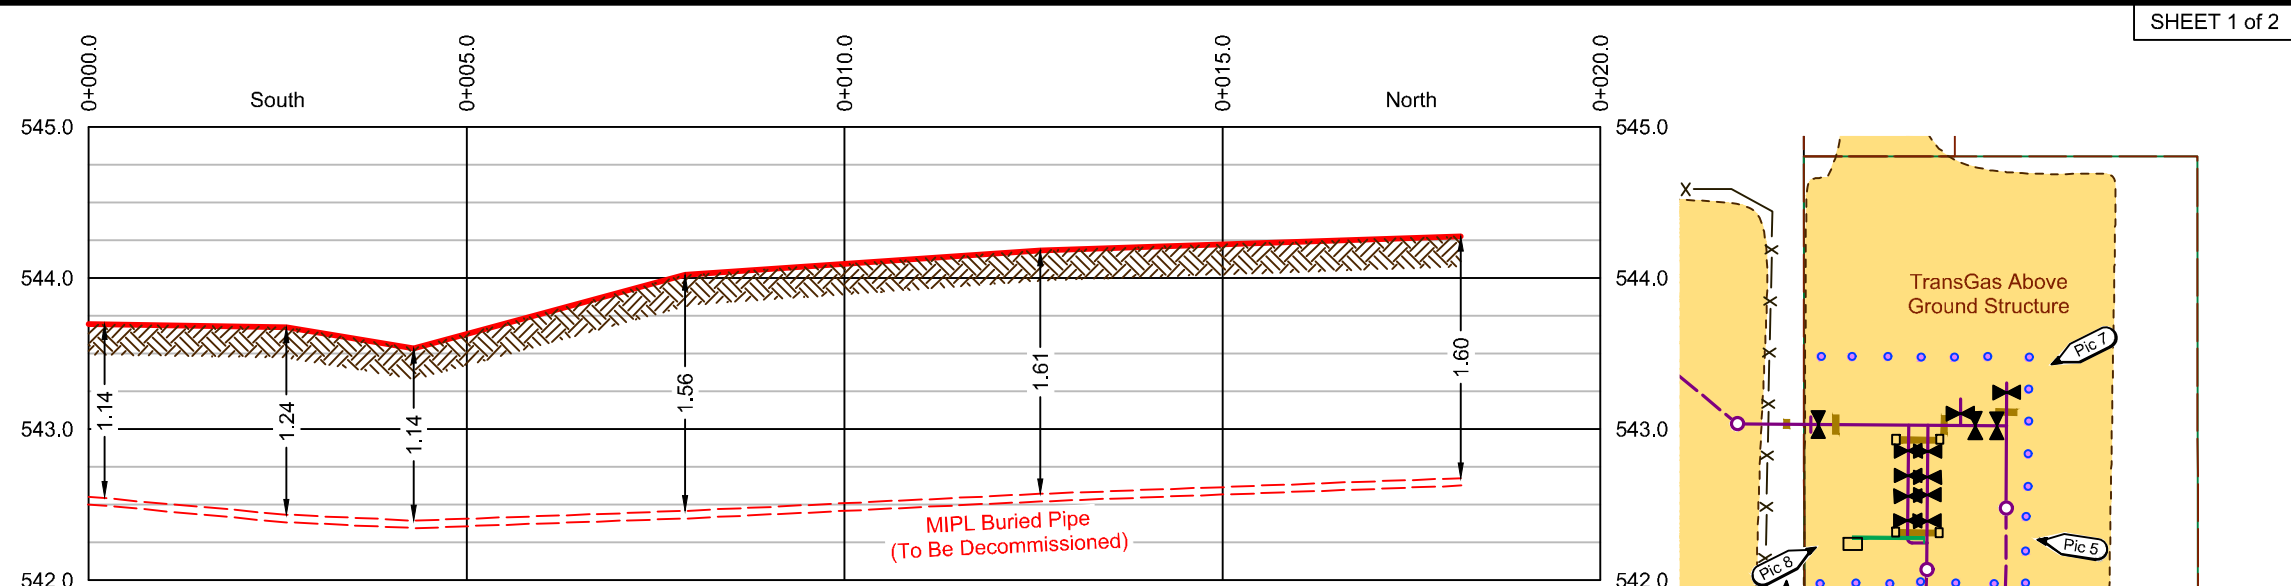

Profile Along MIPL Buried Pipe (To Be Decommissioned)
Scales - 1 : 100 Horiz. 1 : 50 Vert.

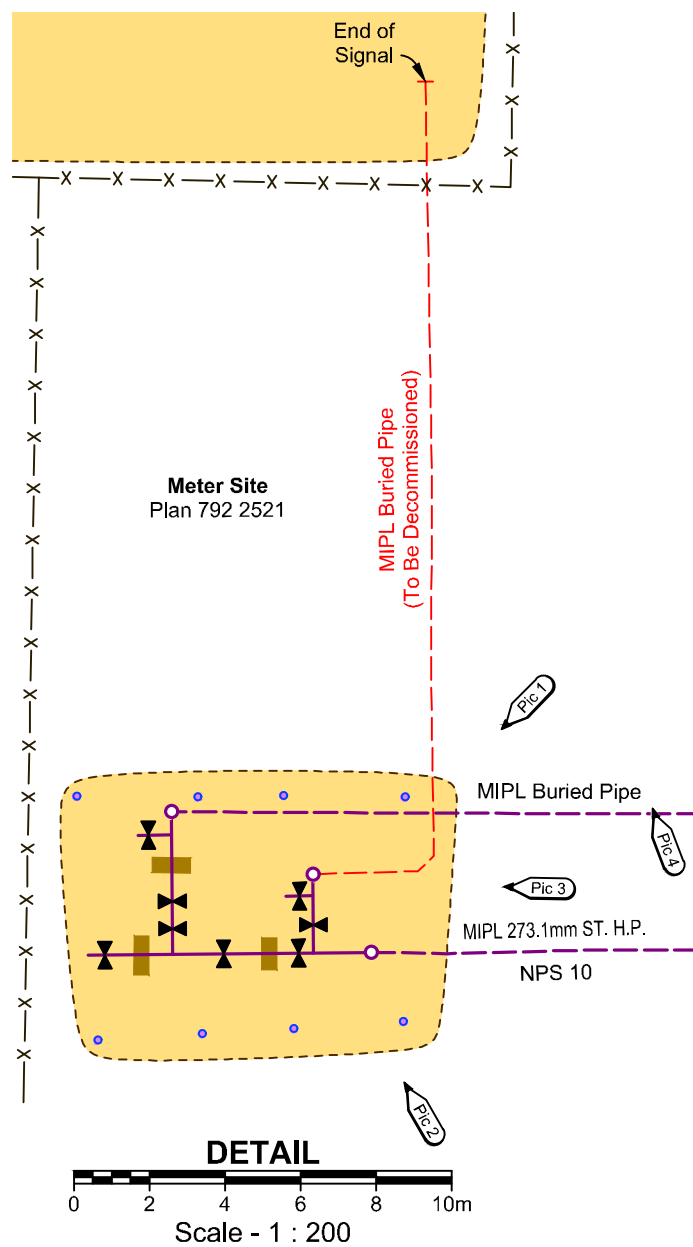

LEGEND



Riser shown thus ---○---

Valve shown thus ---▲---

Buried Pipeline shown thus ---■---

Above Ground Pipeline shown thus ---▲---

Fence shown thus ---X---

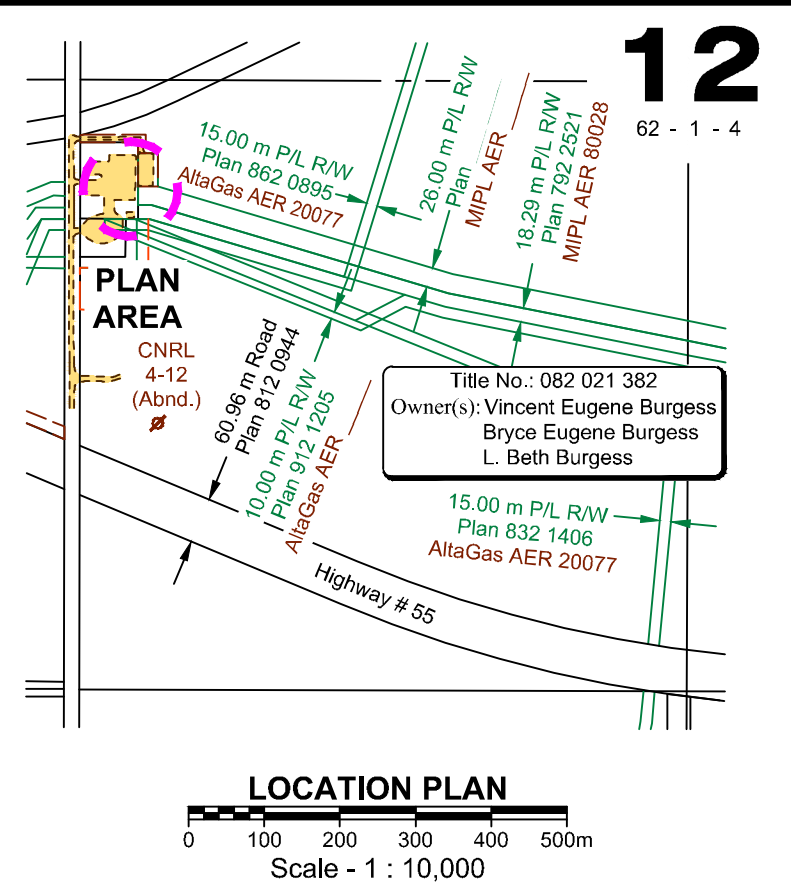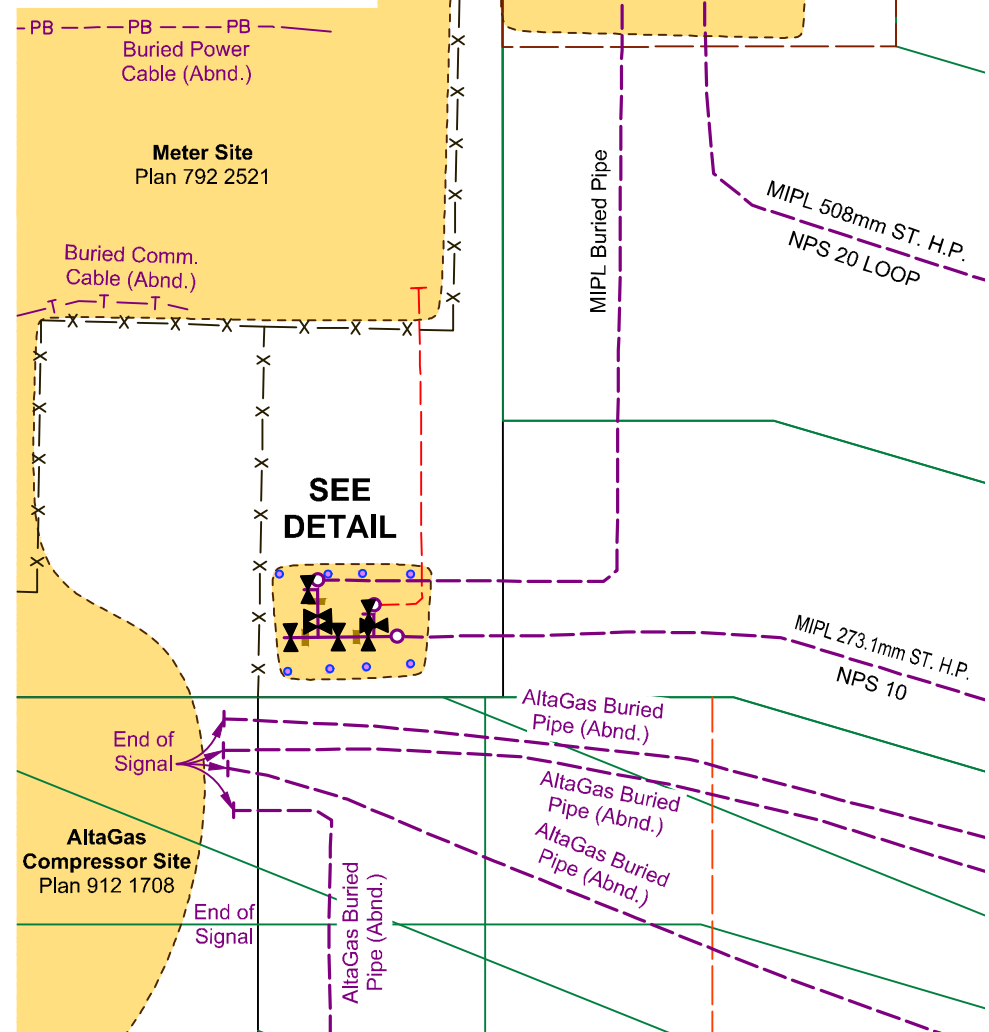

MIPL

As-Built Plan of


**CLBH #1 NPS10 Decommission
Alberta Border - Cold Lake**

in

S.W.1/4 - Sec.12 - Twp.62 - Rge.1 - W.4M.

Municipal District of Bonnyville No. 87

Alberta

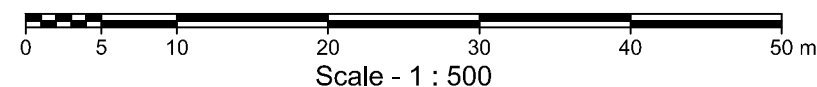

2.	Amended R/W Label	SD - RM	June 20, 2023
1.	Amended Logo	SD - RM	June 20, 2023
0.	Issued	DS - SD - RM	June 19, 2023

NO.	REVISION	BY	DATE
-----	----------	----	------

JCN No.: 202291002	File: 23-02207-001-AB-R2
Survey Date: June 8, 2023	Job No.: 23-02207-001

GeoVerra

GeoVerra Inc.
Toll Free: 1-800-465-6233
www.geoverra.com
© 2023 GeoVerra Inc.



Pic 1



Pic 2



Pic 3



Pic 4



Pic 5



Pic 6



Pic 7



Pic 8



Pic 9